## THE BOARD OF COMMISSIONERS TODD H. STROGER PRESIDENT

EARLEAN COLLINS 1" Dist. PETER N. SILVESTRI 9" DIST. PETE



COOK COUNTY
BUREAU OF ADMINISTRATION
DEPARTMENT OF HIGHWAYS
Rupert F. Graham Jr., P.E.
Superintendent
George W. Dunne Cook County Office Building
69 West Washington Street 23<sup>rd</sup> Floor
Chicago, Illinois 60602-3007
Telephone (312) 603-1601
Fax (312) 603-9945

March 10, 2008

Commissioner John D. Powers Palatine Township 530 North Smith Road Palatine. Illinois 60067

RE: Briarwood Lane at Salt Creek

Structure Number: 016-4000

Palatine Township

## Dear Powers:

The Cook County Highway Department is preparing plans for the improvement of a triple box culvert at the subject location. The proposed improvements to the culvert consist of the removal and replacement of the guardrail with traffic barrier terminal, Type 6 and traffic barrier terminal, Type 1 with bituminous shoulders; removal and replacement of the bituminous surface with a sheet water proofing membrane system; structural repairs of concrete to the triple box culvert and wing walls; deck slab repairs near deck drains; replace deck drains; and perform epoxy crack sealing and all collateral work as necessary to complete the project. This Improvement is located in the unincorporated area of Palatine Township.

Enclosed is a location map and preliminary plan sheet showing the proposed improvements. Please plot your existing facilities on the plan sheet and return to us. When plotting your facilities provide a size and dimension with reference to the centerline of the road. In addition please review the plan carefully and assess your involvement. There is an electrical meter box at the southwest corner of the box culvert (see attached pictures).

Please submit the marked up plan and atlas pages indicating your facilities to this office by April 4, 2008. Your prompt response would be appreciated. If you have any questions or need additional information regarding this improvement, please contact Ram Kuchipudi, Utilities Section Head, at (312) 603-1712.

Very truly yours,

Frank J. Williams, P.E., S.E. Chief Engineer, Design Bureau


Office Engineer, Doorger Davison


FOR: Theodore P. Georgas, P.E., S.E. Assistant Superintendent of Highways

Cook County, Illinois

## **Enclosures**

H:\Design\Drainage\Drainage and Utilities\Land.99\Land Companies\Brianwood Lane at Salt Creek-culvert repairs Letters to att&palatine township 3-10-08 doc

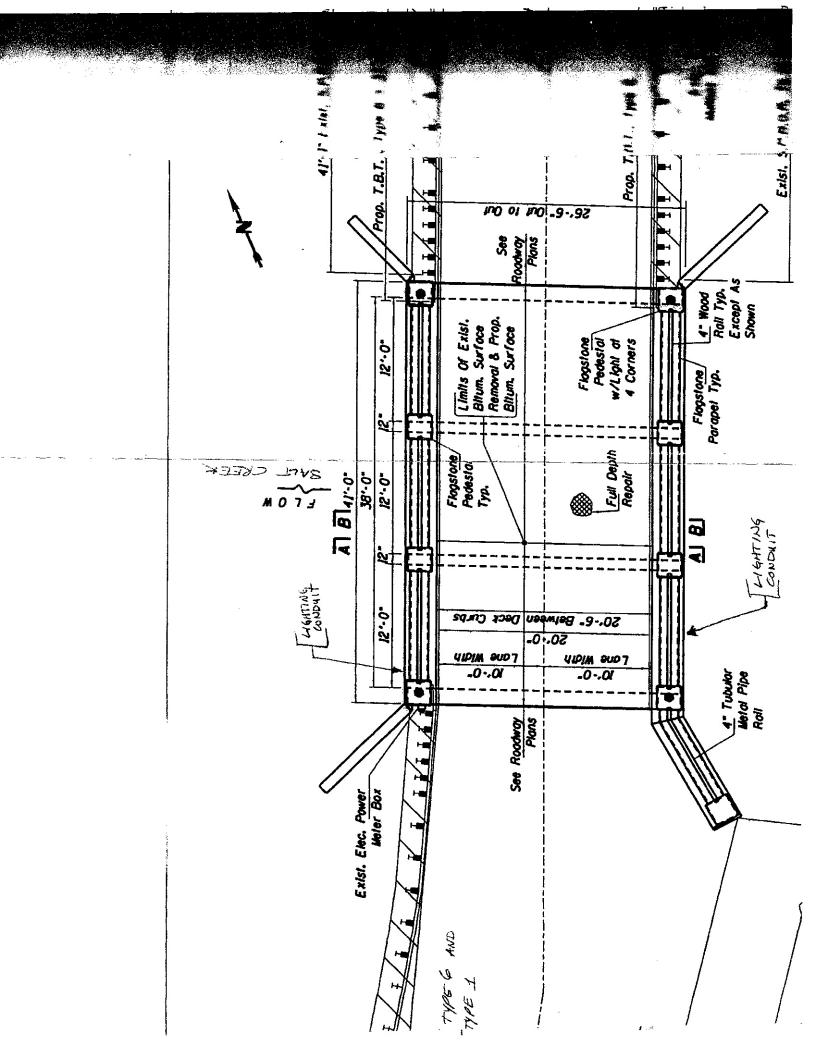

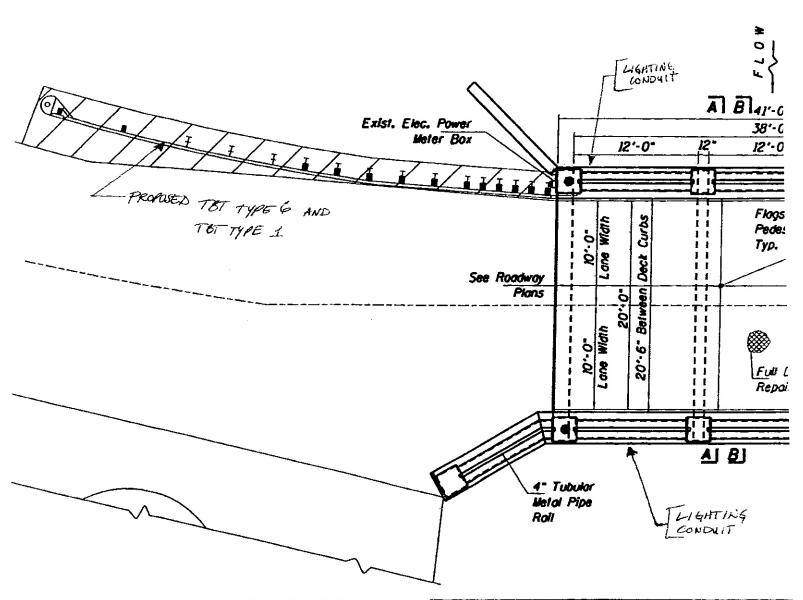

...\design files\GENERAL PLAN.DGN 2/13/2008 9:47:04 AM



